



Property Location
Legal Description
Lot 24 and the East 1/2 of Lot 25, in Block 5, Coral Gables Section "E", according to the Plat thereof, recorded in Plat Book 8, Page 13, of the Public Records of Miami-Dade County, Florida.




1229 Astoria Avenue
Coral Gables, Florida 33134

National Flood Insurance
Community Panel: 12086C0294L
Flood Zone: X
Base Flood Elevation: n/a
Firm Date: 09/11/2009


Certified to:
RUSSELL C WILKINSON
EILEEN G WILKINSON

Survey Date: 06/13/2023
Job Number: 23-2058
Order Number:
Revision:

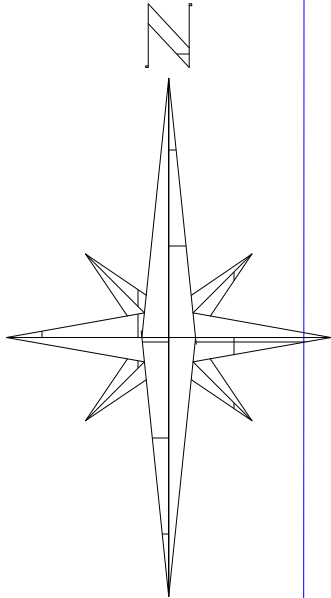

SURVEY MAP

SCALE: 1"= 20'

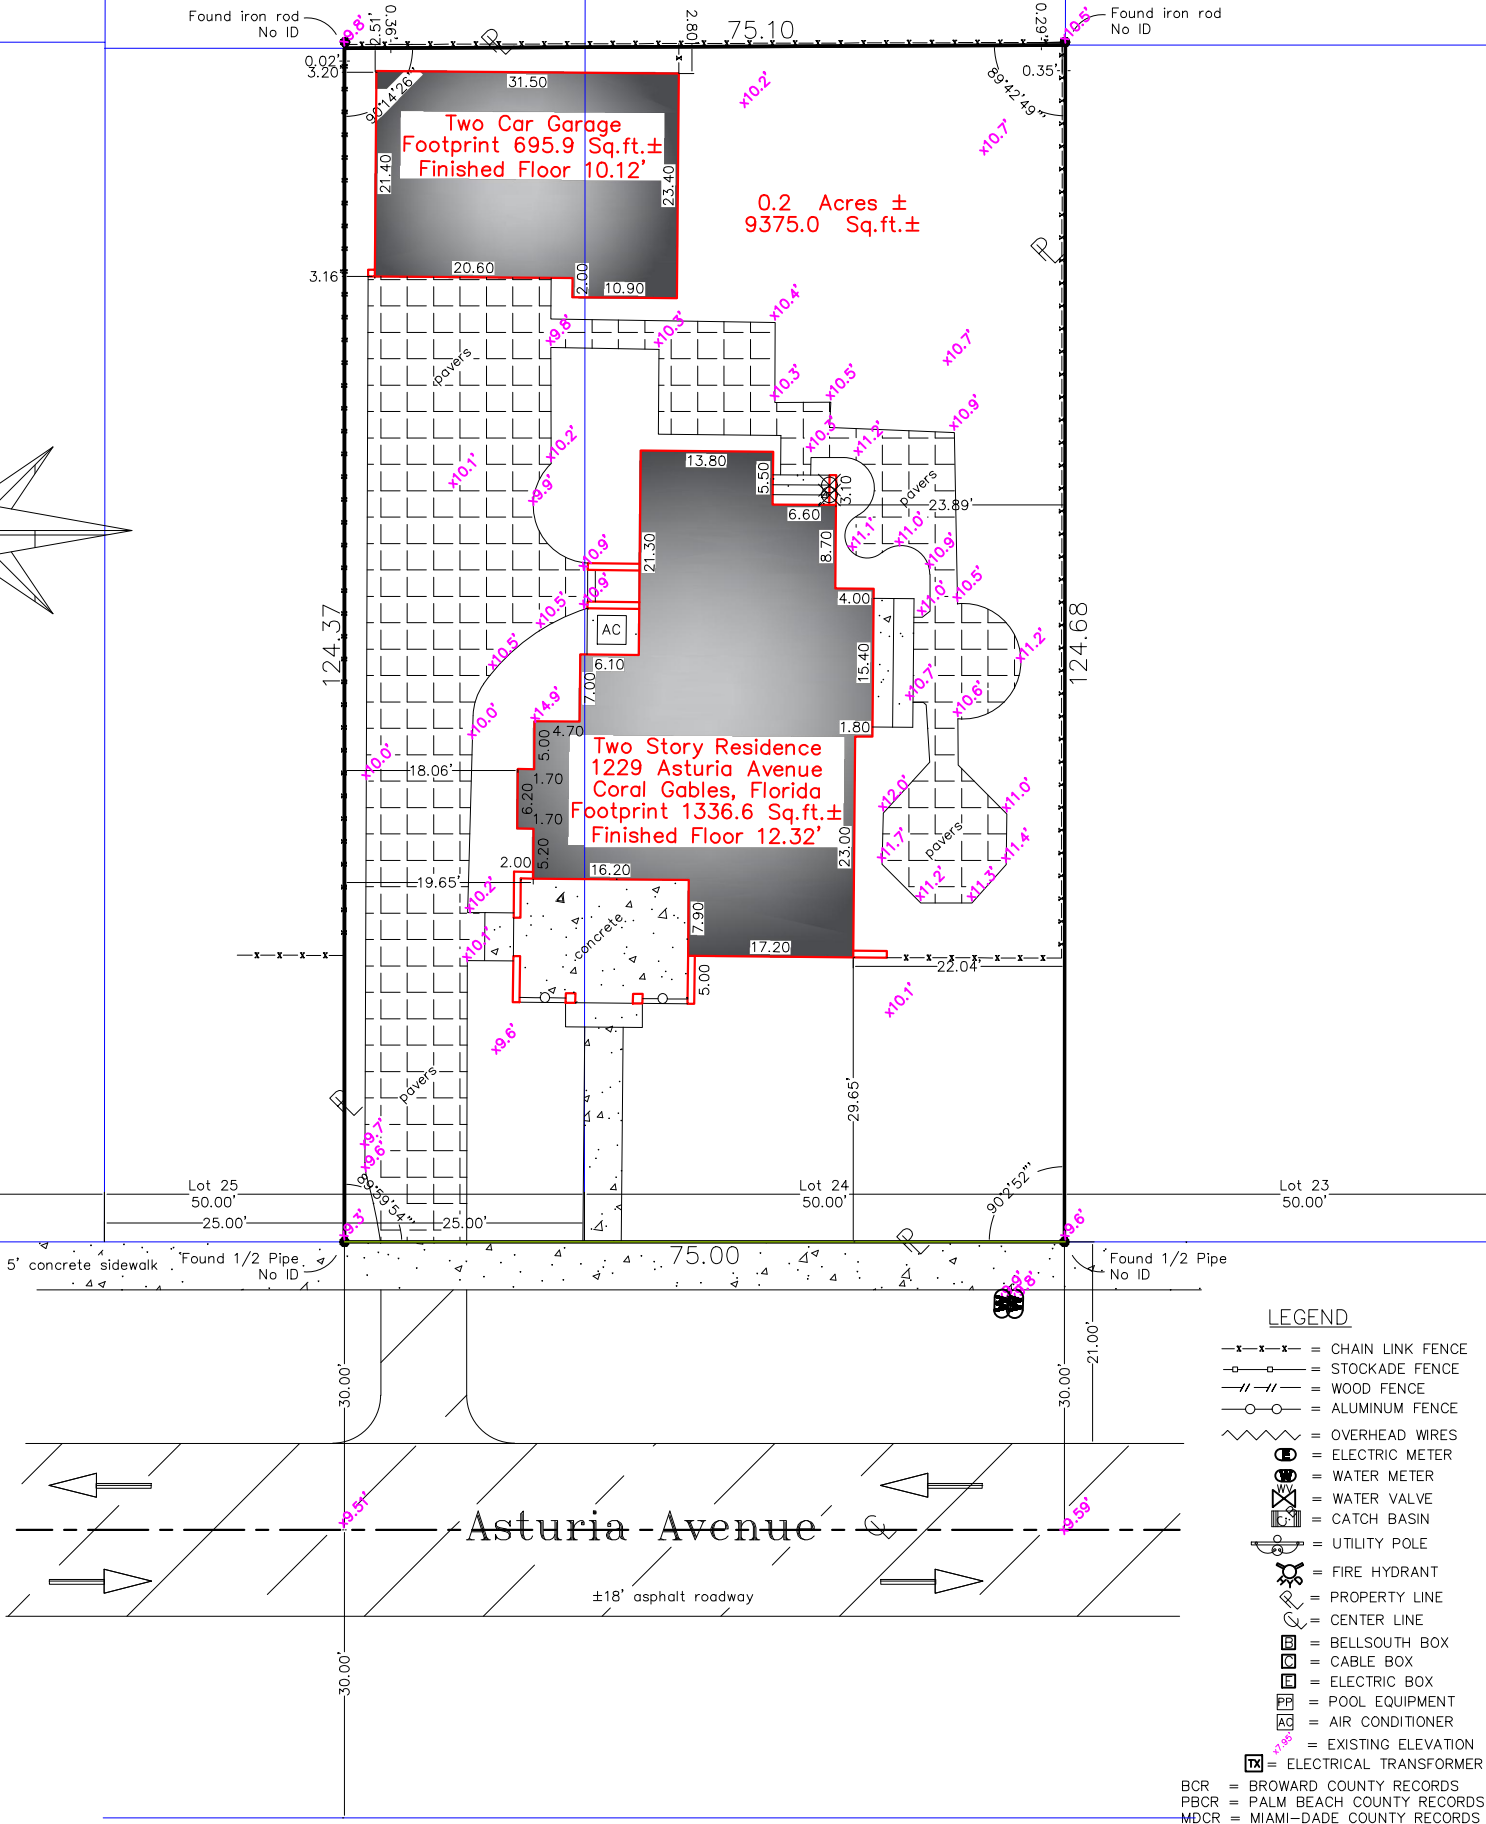


SURVEYORS NOTES

- This is a Topographic survey.
- Legal description used for this survey was provided by others.
- This Survey has been prepared for the exclusive use of the entities named hereon and do not extend to any unnamed parties.
- The lands shown herein were not abstracted for easement or other recorded encumbrances not shown on the plat Obtain current title work and verify easements before constructing improvements.
- This survey does not determine or imply ownership.
- This survey only shows above ground improvements, underground improvements and utilities were not located.
- Bearings, if any, shown hereon are based on Plat Book 8, Page 13, of the Public Records of Miami-Dade County, Florida.
- All dimensions and directions shown hereon are in substantial agreement with record values unless otherwise noted.
- Due to varying construction standards, house dimensions are approximate.
- All ties to property line are perpendicular to it, unless otherwise noted.
- In all cases dimensions shall control location over scaled positions.
- Elevations, if shown, are based of NAVD88, Benchmark F.D.O.T. N.T.R.I.P. stations (FTLD & LAUD).
- If there is a septic tank, well, or drain field marked on this survey, the location of such items was shown to us by others and the information was not verified.
- Not valid without the signature & raised seal of a Florida licensed surveyor and mapper.

I HEREBY CERTIFY THAT THE SURVEY REPRESENTED HEREON, AS RECENTLY SURVEYED AND DRAWN UNDER MY SUPERVISION, MEETS THE MINIMUM TECHNICAL STANDARDS AS SET FORTH IN CHAPTER 5J-17 OF THE FLORIDA ADMINISTRATIVE CODE FOR THE BOARD OF PROFESSIONAL SURVEYORS AND MAPPERS PURSUANT TO SECTION 472.027 OF THE FLORIDA STATUTES.

No part of this drawing may be reproduced by photocopying, recording or by any other means, or stored, processed or transmitted in or by any computer or other systems without the prior written permission of R. Minguell Land Surveyors. Copies of this plan without an original signature and impression seal are not valid.

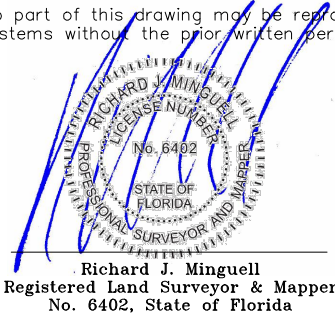

R. Minguell, Inc.

Land Surveyors & Planners L.B.7272
591 S.W. 112 Avenue
Plantation, Florida 33325
954-298-8935
Minguell@bellsouth.net
RMinguell.com